
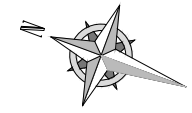
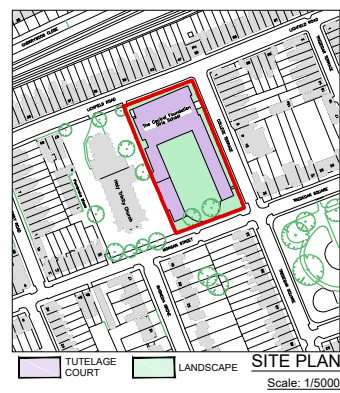


**GENERAL NOTES:**  
 1. ALL THE PROPOSED LAYOUT IS DRAWN IN ACCORDANCE WITH THE APPROVED DRAWINGS FROM THE ARCHITECT.

- KEY:**
- FLAT 17 - (72.7m<sup>2</sup> OR 782.53ft<sup>2</sup>)
  - FLAT 3 - (58.1m<sup>2</sup> OR 625.38ft<sup>2</sup>)
  - FLAT 1 - (63.1m<sup>2</sup> OR 679.20ft<sup>2</sup>)
  - FLAT 6 - (64.6m<sup>2</sup> OR 695.34ft<sup>2</sup>)

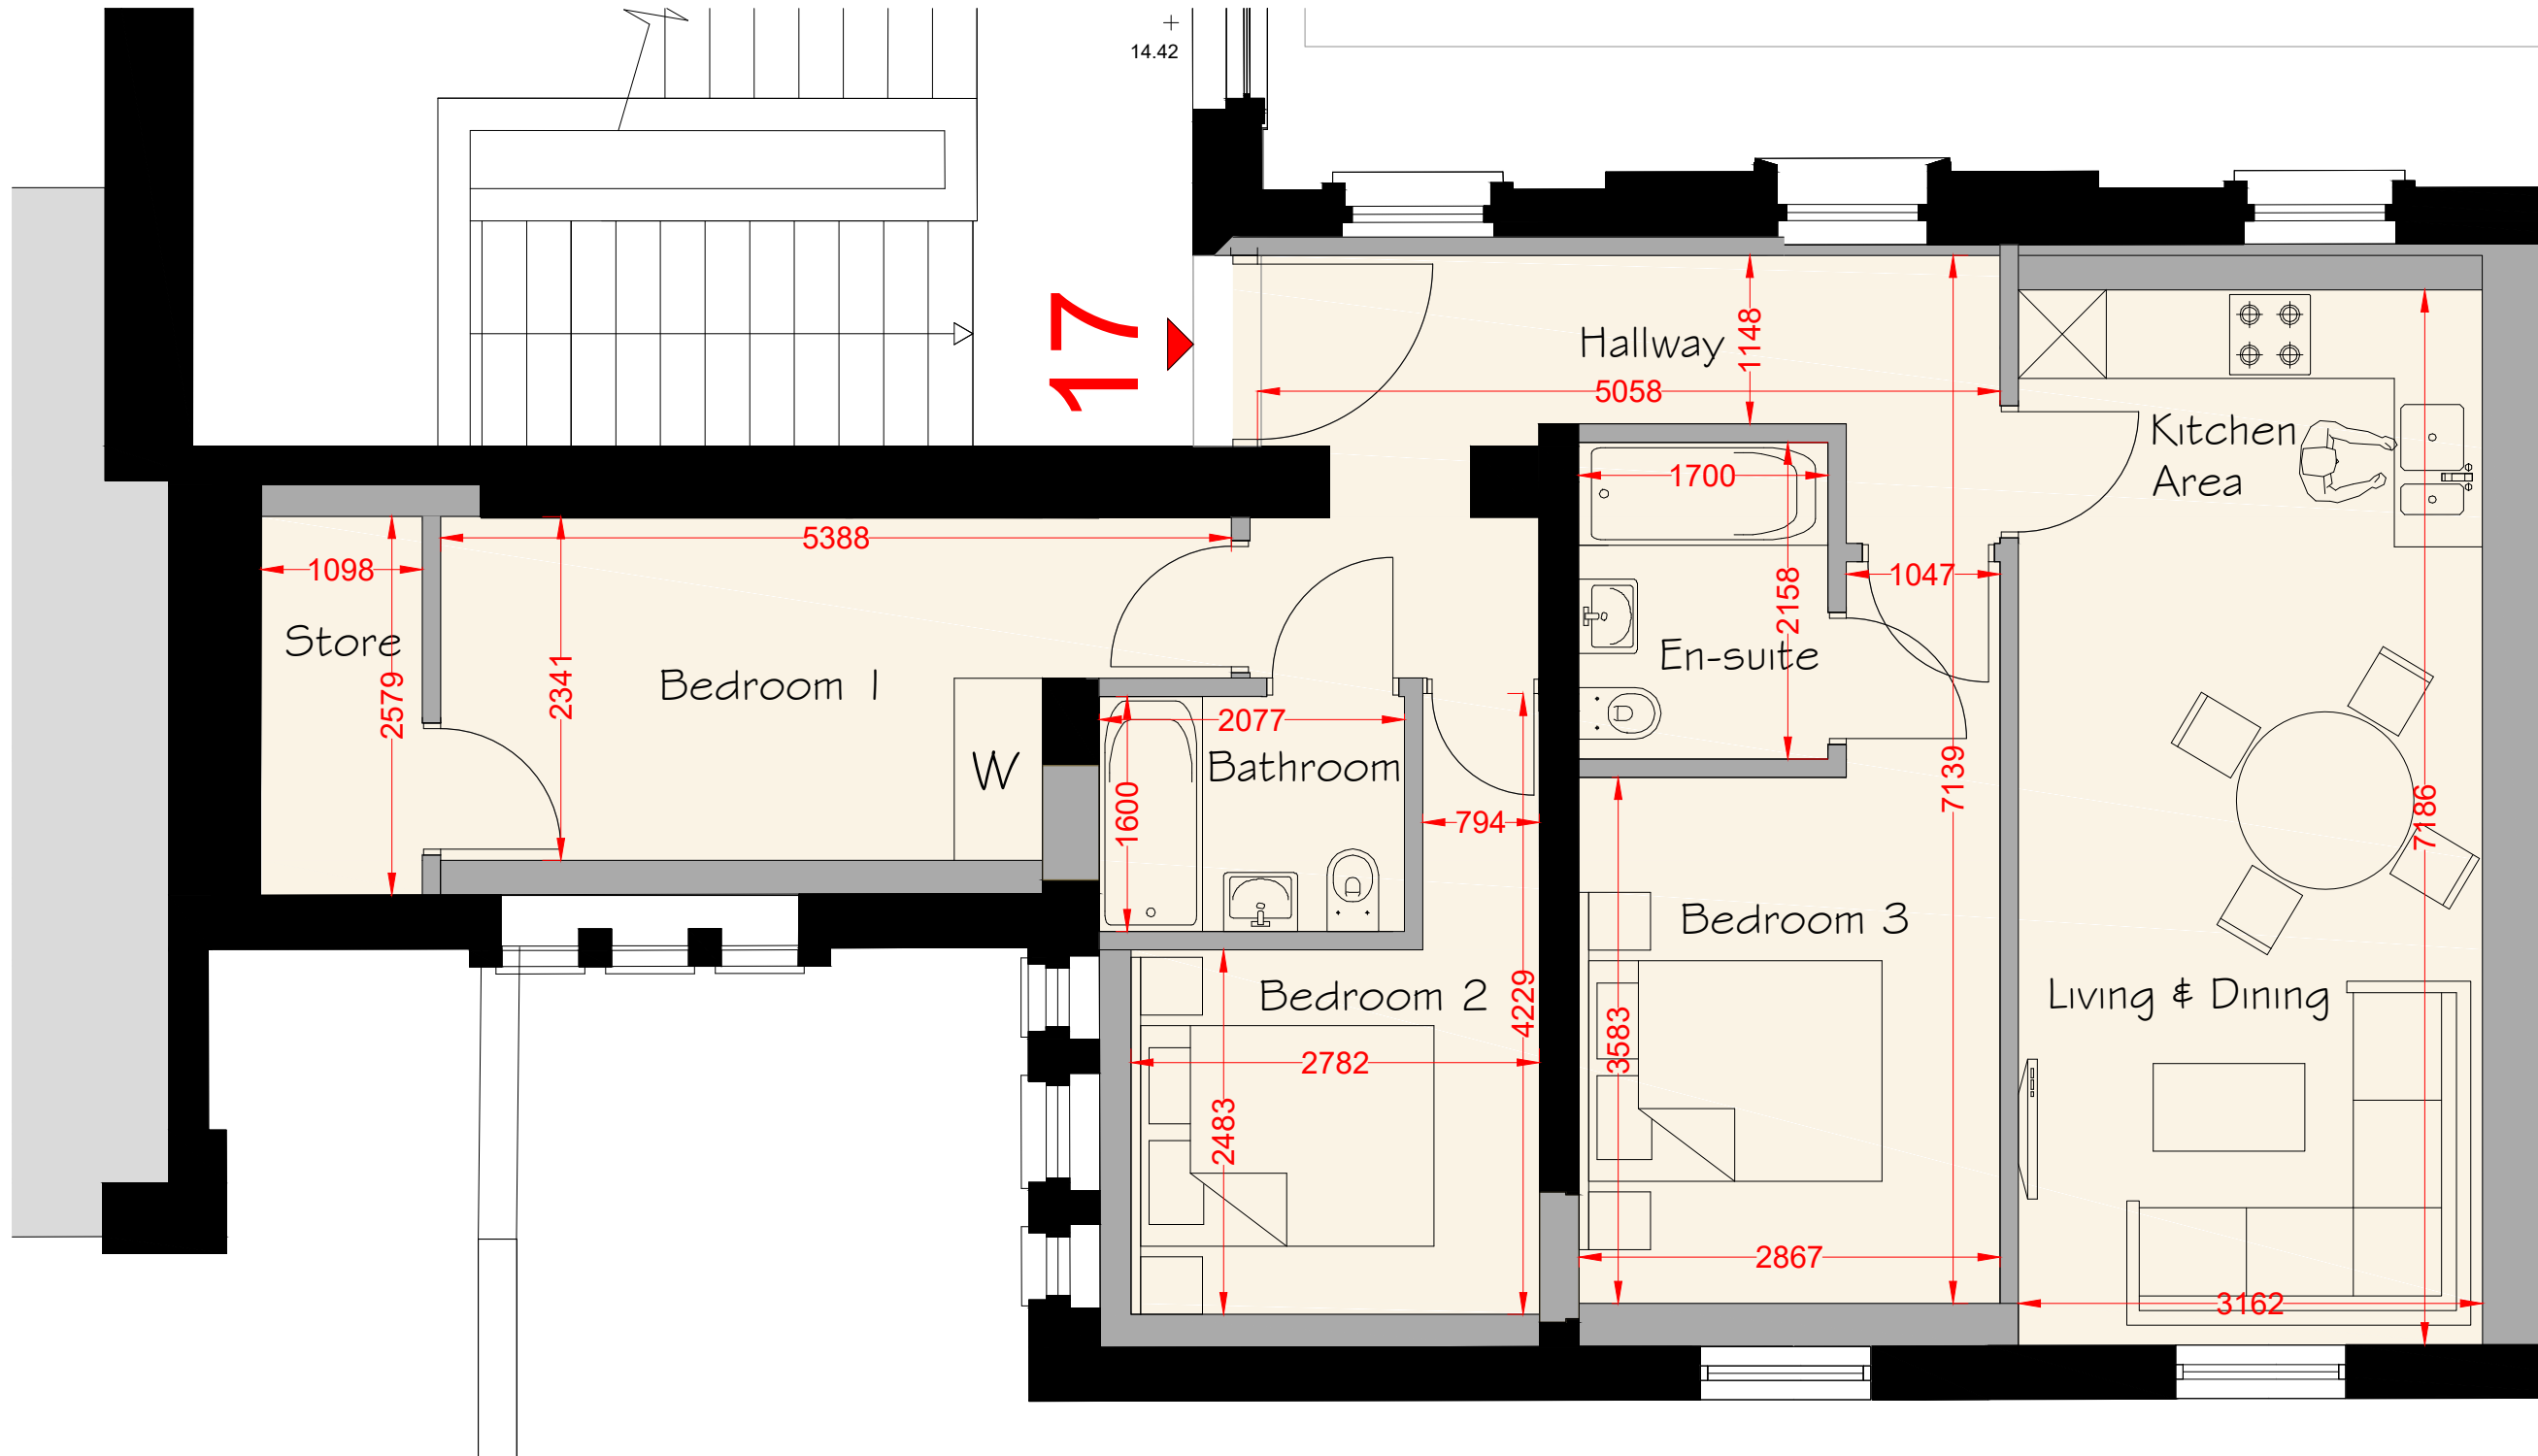

**FLAT 17 - Tutelage Court**  
 Scale: 1/50

A	As Built	09-11-16
Rev	Description	Date

All dimensions and levels to be checked on site by contractor prior to preparation of shop drawings and commencement of work on site. Do not scale from this drawing or reproduce without consent.  
 This drawing and the design is the copyright and property of Jaspargroup and may not be used in part or in whole without prior written consent.  
 This drawing is to be read in conjunction with all relevant consultants and/or specialist's drawings/documents and any discrepancies or variations are to be notified to Jaspargroup before the affected work commences.




**PROJECT:**  
 Tutelage Court,  
 31 College Terrace,  
 London,  
 E3 5AN

**DRAWING:**  
 FLAT 17 - Tutelage Court

DWN: ABP	CKD: LC	DATE: 09/11/16	STATUS: PLANNING
SCALE: 1:50	DWG NO: JM038 - TC - DIM - 017	PAGE: 1 OF 1	REV: A

**GENERAL NOTES:**  
 1. ALL THE PROPOSED LAYOUT IS DRAWN IN ACCORDANCE WITH THE APPROVED DRAWINGS FROM THE ARCHITECT.

- KEY:**
- FLAT 17 - (72.7m<sup>2</sup> OR 782.53ft<sup>2</sup>)
  - FLAT 3 - (58.1m<sup>2</sup> OR 625.38ft<sup>2</sup>)
  - FLAT 1 - (63.1m<sup>2</sup> OR 679.20ft<sup>2</sup>)
  - FLAT 6 - (64.6m<sup>2</sup> OR 695.34ft<sup>2</sup>)

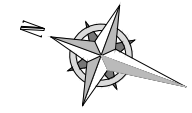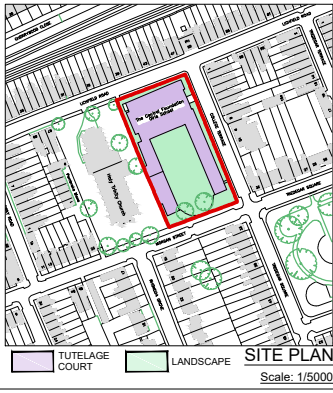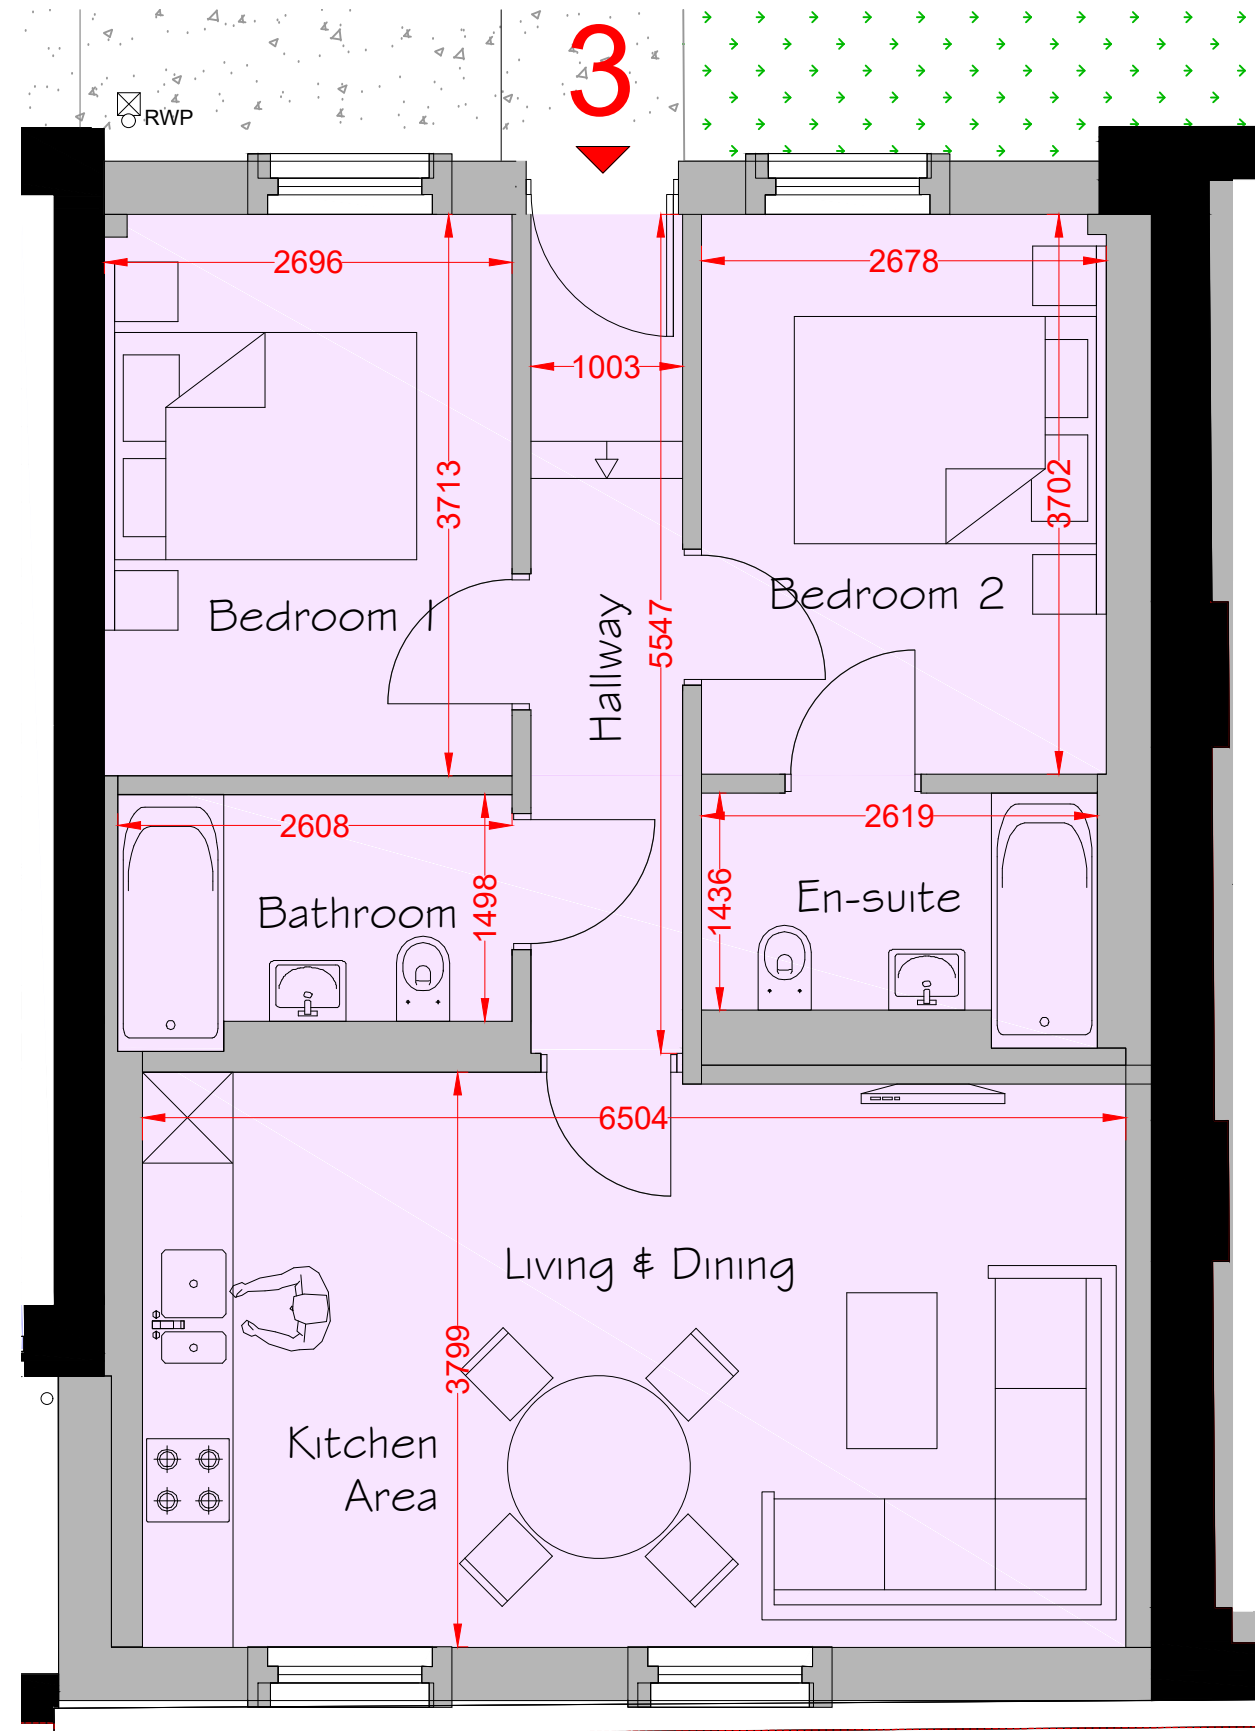

**FLAT 3 - Edicule Square**  
 Scale: 1/50

A	As Built	09-11-16
Rev	Description	Date

All dimensions and levels to be checked on site by contractor prior to preparation of shop drawings and commencement of work on site. Do not scale from this drawing or reproduce without consent.  
 This drawing and the design is the copyright and property of Jaspargroup and may not be used in part or in whole without prior written consent.  
 This drawing is to be read in conjunction with all relevant consultants and/or specialist's drawings/documents and any discrepancies or variations are to be notified to Jaspargroup before the affected work commences.



**PROJECT:**  
 Edicule Square,  
 London,  
 E3 5SD

**DRAWING:**  
 FLAT 3 - Edicule Square

DWN: ABP	CKD: LC	DATE: 09/11/16	STATUS: PLANNING
SCALE: 1:50	DWG NO: JM038 - TC - DIM - 028	PAGE: 1 OF 1	REV: A

**GENERAL NOTES:**  
 1. ALL THE PROPOSED LAYOUT IS DRAWN IN ACCORDANCE WITH THE APPROVED DRAWINGS FROM THE ARCHITECT.

- KEY:**
- FLAT 17 - (72.7m<sup>2</sup> OR 782.53ft<sup>2</sup>)
  - FLAT 3 - (58.1m<sup>2</sup> OR 625.38ft<sup>2</sup>)
  - FLAT 1 - (63.1m<sup>2</sup> OR 679.20ft<sup>2</sup>)
  - FLAT 6 - (64.6m<sup>2</sup> OR 695.34ft<sup>2</sup>)

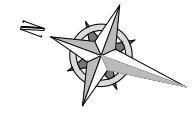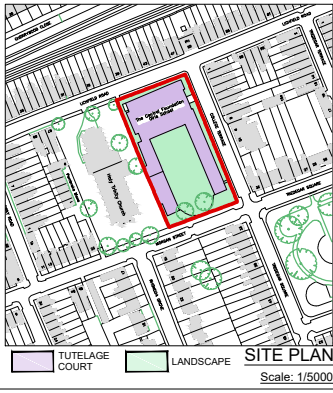

**FLAT 1 - Edicule Square**  
 Scale: 1/50

Rev	Description	Date
A	As Built	09-11-16

All dimensions and levels to be checked on site by contractor prior to preparation of shop drawings and commencement of work on site. Do not scale from this drawing or reproduce without consent.  
 This drawing and the design is the copyright and property of Jaspargroup and may not be used in part or in whole without prior written consent.  
 This drawing is to be read in conjunction with all relevant consultants and/or specialist's drawings/documents and any discrepancies or variations are to be notified to Jaspargroup before the affected work commences.




**PROJECT:**  
 Edicule Square,  
 London,  
 E3 5SD

**DRAWING:**  
 FLAT 1 - Edicule Square

DWN: ABP	CKD: LC	DATE: 09/11/16	STATUS: PLANNING
SCALE: 1:50	DWG NO: JM038 - TC - DIM - 032	PAGE: 1 OF 1	REV: A

**GENERAL NOTES:**  
 1. ALL THE PROPOSED LAYOUT IS DRAWN IN ACCORDANCE WITH THE APPROVED DRAWINGS FROM THE ARCHITECT.

- KEY:**
- FLAT 17 - (72.7m<sup>2</sup> OR 782.53ft<sup>2</sup>)
  - FLAT 3 - (58.1m<sup>2</sup> OR 625.38ft<sup>2</sup>)
  - FLAT 1 - (63.1m<sup>2</sup> OR 679.20ft<sup>2</sup>)
  - FLAT 6 - (64.6m<sup>2</sup> OR 695.34ft<sup>2</sup>)

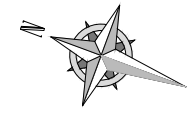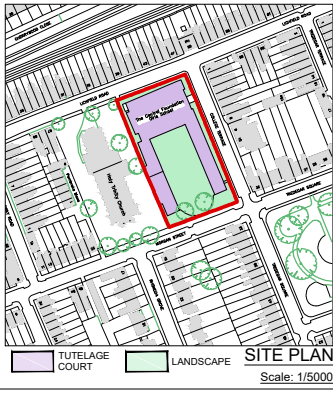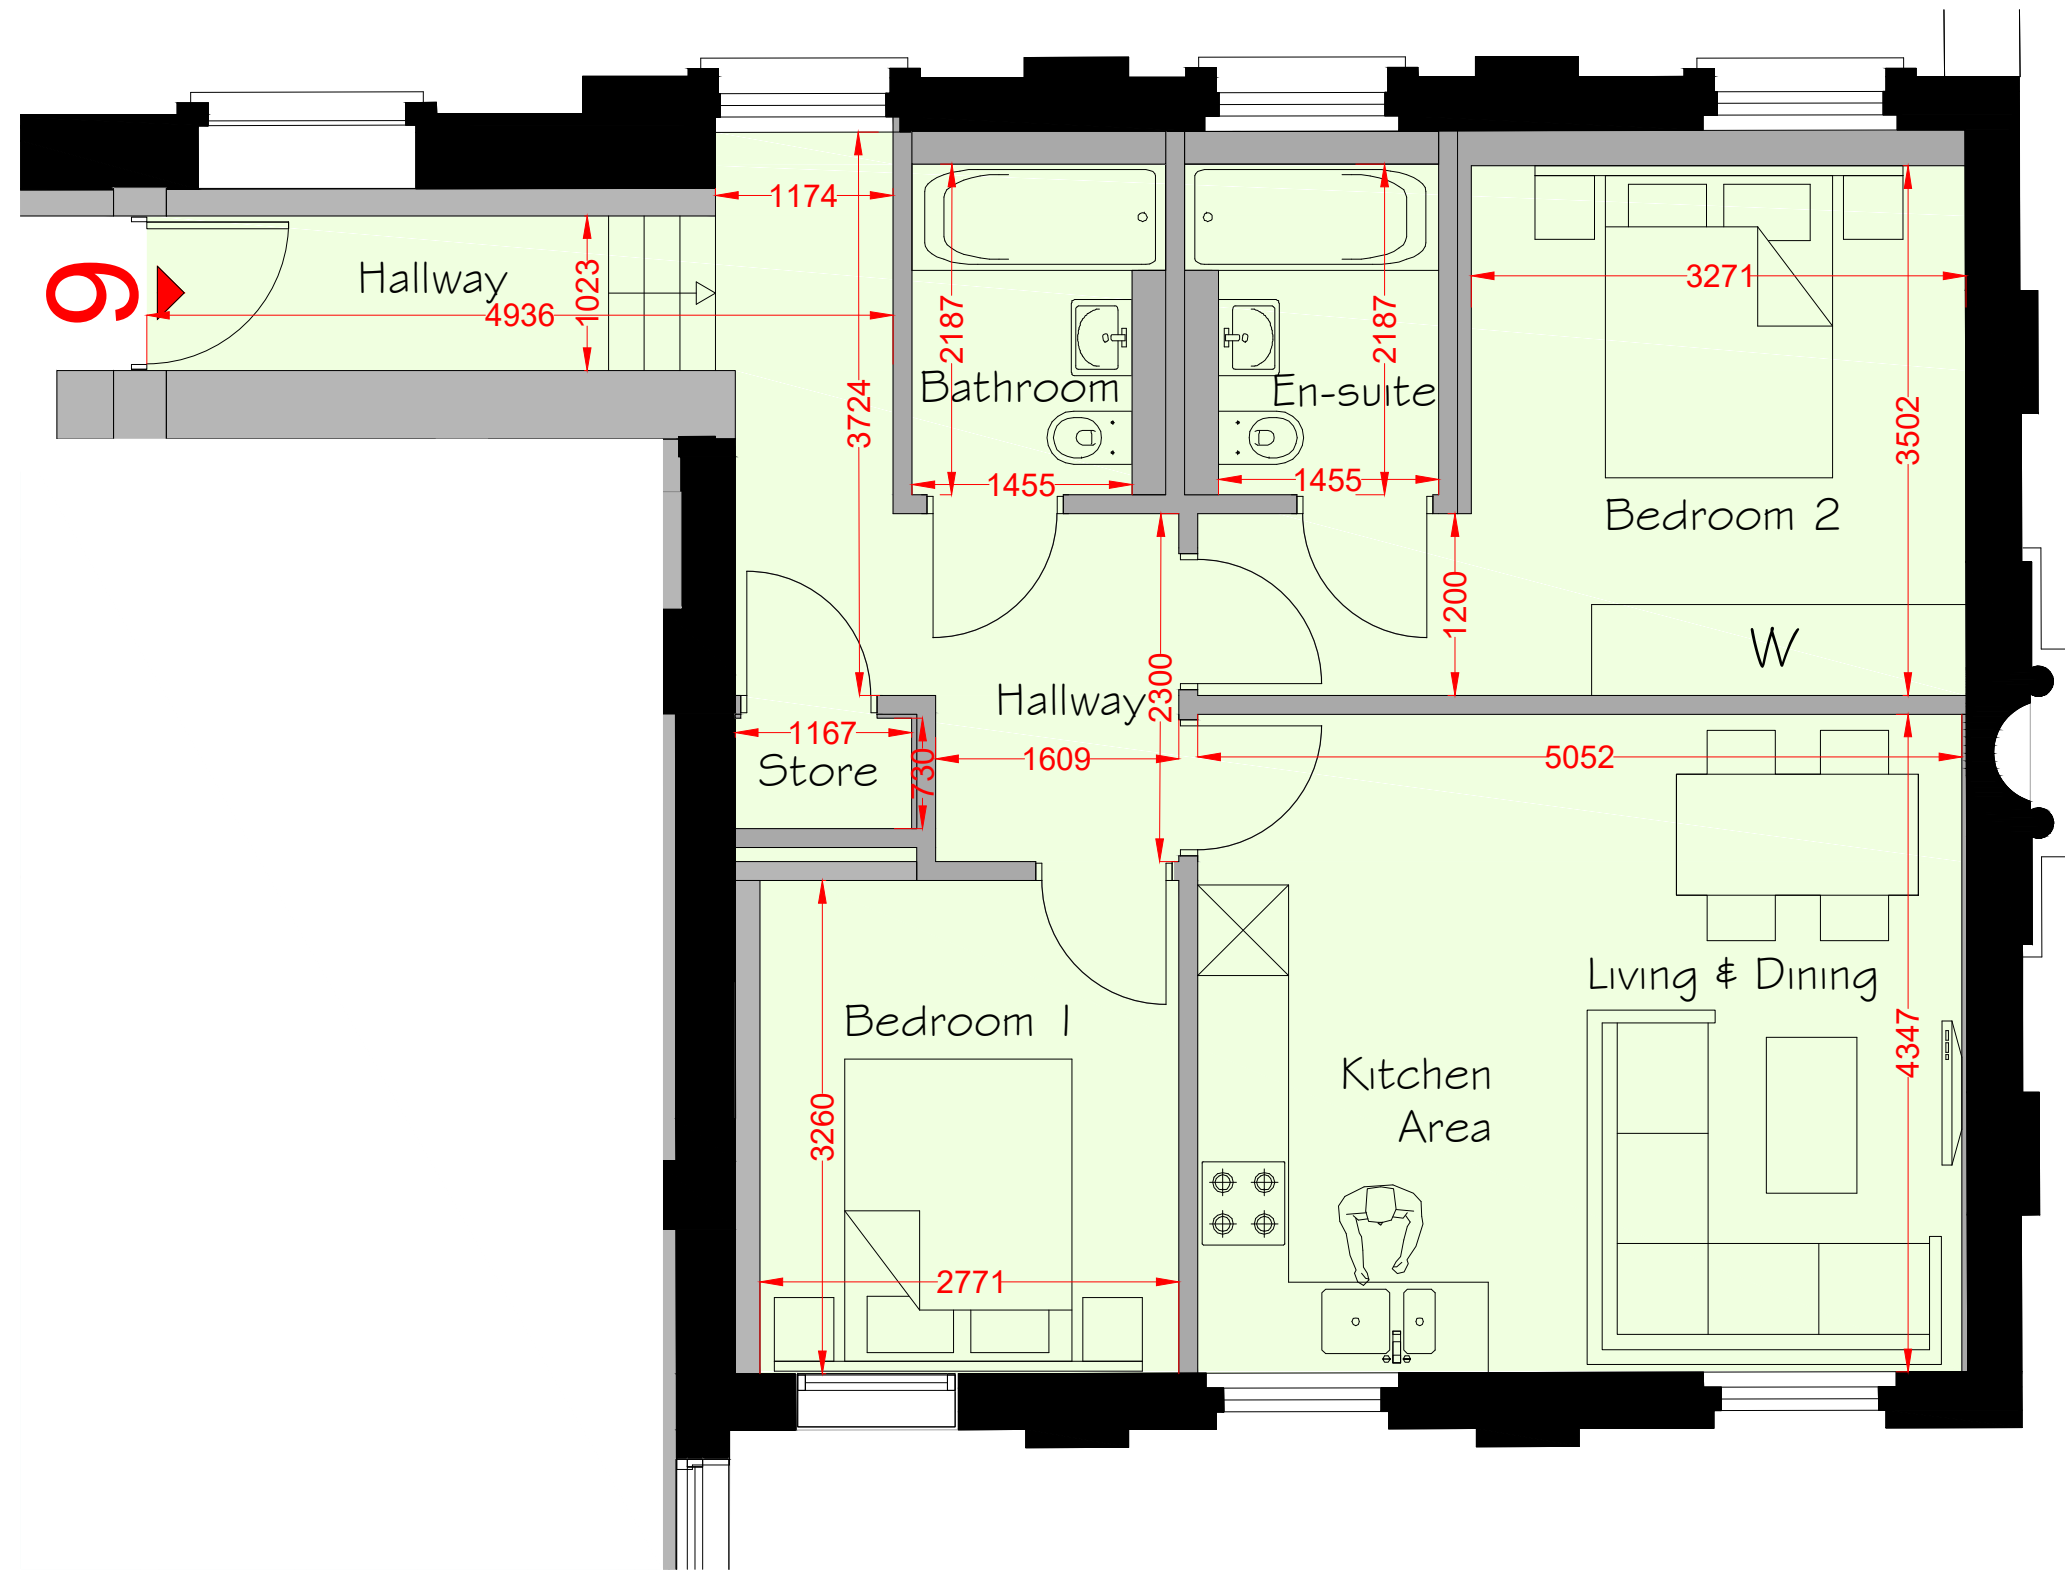

## FLAT 6 - Pedantry Apartments

Scale: 1/50

Rev	Description	Date
A	As Built	09-11-16

All dimensions and levels to be checked on site by contractor prior to preparation of shop drawings and commencement of work on site. Do not scale from this drawing or reproduce without consent.  
 This drawing and the design is the copyright and property of Jasper Group and may not be used in part or in whole without prior written consent.  
 This drawing is to be read in conjunction with all relevant consultants and/or specialist's drawings/documents and any discrepancies or variations are to be notified to Jasper Group before the affected work commences.

**PROJECT:**  
 Edicule Square,  
 London,  
 E3 5SD

**DRAWING:**  
 FLAT 6 - Pedantry Apartments

DWN: ABP	CKD: LC	DATE: 09/11/16	STATUS: PLANNING
SCALE: 1:50	DWG NO: JM038 - TC - DIM - 036	PAGE: 1 OF 1	REV: A